

**SCDHEC OFFICE OF OCEAN AND COASTAL RESOURCE MANAGEMENT
PERMIT APPLICATION PUBLIC NOTICE**

March 31, 2006

Permit Number: OCRM-06-512
Permit ID: 54396

The SCDHEC Office of Ocean and Coastal Resource Management has received an application for a permit for the alteration of a critical area. This application was submitted pursuant to the Coastal Zone Management Act (Act 123) of the 1977 South Carolina General Assembly. The application, in brief, is described as follows:

APPLICANT: Robby Causey
PO Box 992
Murrells Inlet, SC 29576

LOCATION: On and adjacent to Oyster Cove at 2080 Pampano Dr, Murrells Inlet, Georgetown County, South Carolina.
TMS#: 41-131-032.

WORK: The work, as proposed, consists of the removal of the existing dock structure which is a walkway, fixed dock and floating dock. Reconstruction of the 4'x20' walkway (with handrails), 10'x10' fixed dock (with roof and handrails) and a 3'x18' aluminum hinged ramp that will lead to a 5'x32' (190 sf) floating dock. The dock structure will be moved out into the channel by 15'. The purpose of the proposed activity is for the applicant's private, recreational use.

This public notice is being distributed to all known interested persons and agencies to assist in developing facts on which a decision by OCRM can be based. Comments concerning the proposed work should be submitted in writing, setting forth sufficient detail to furnish a clear understanding of the reasons for support or opposition.


The decision to issue or deny a permit will be based on the individual merits of the application, the policies specified in the South Carolina Coastal Zone Management Act, and the considerations outlined in the State of South Carolina Coastal Zone Management Program. Interested parties who wish to be notified of final permit action must notify OCRM in writing of this request.


To assure review by OCRM, comments regarding this application must be received by OCRM on or before April 15, 2006. For further information please contact the project manager for this activity, Cindy Fitzgerald, at 843-238-4528 ext. 152.

PLEASE REPLY TO:

SCDHEC OFFICE OF OCEAN AND COASTAL RESOURCE MANAGEMENT
927 Shine Avenue
Myrtle Beach, SC 29577

Please refer to P/N# OCRM-06-512

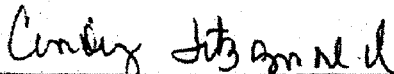
Cindy Fitzgerald, Environmental Manager

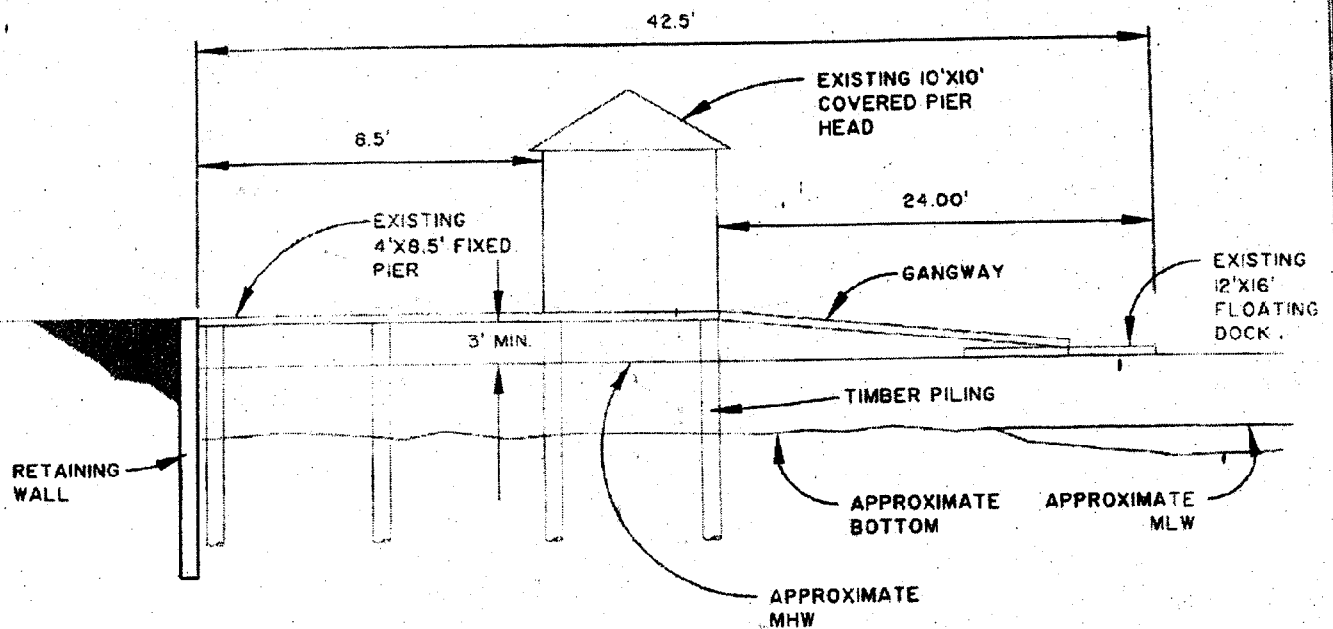

#12799

CONSTRUCTION

William Wells

EXISTING DOCK PROFILE

NOT TO SCALE

DATE: MARCH 2, 2006

REVISED:

SHEET 4 OF 4


PROPOSED ACTIVITY:
PRIVATE RESIDENTIAL DOCK

COUNTY: GEORGETOWN

APPLICANT: ROBBY CAUSEY

OCRM-06-512

9/1/06 Causey, Robby Causey, No. 2-9 Ver. 4, 2006 - 0186-4

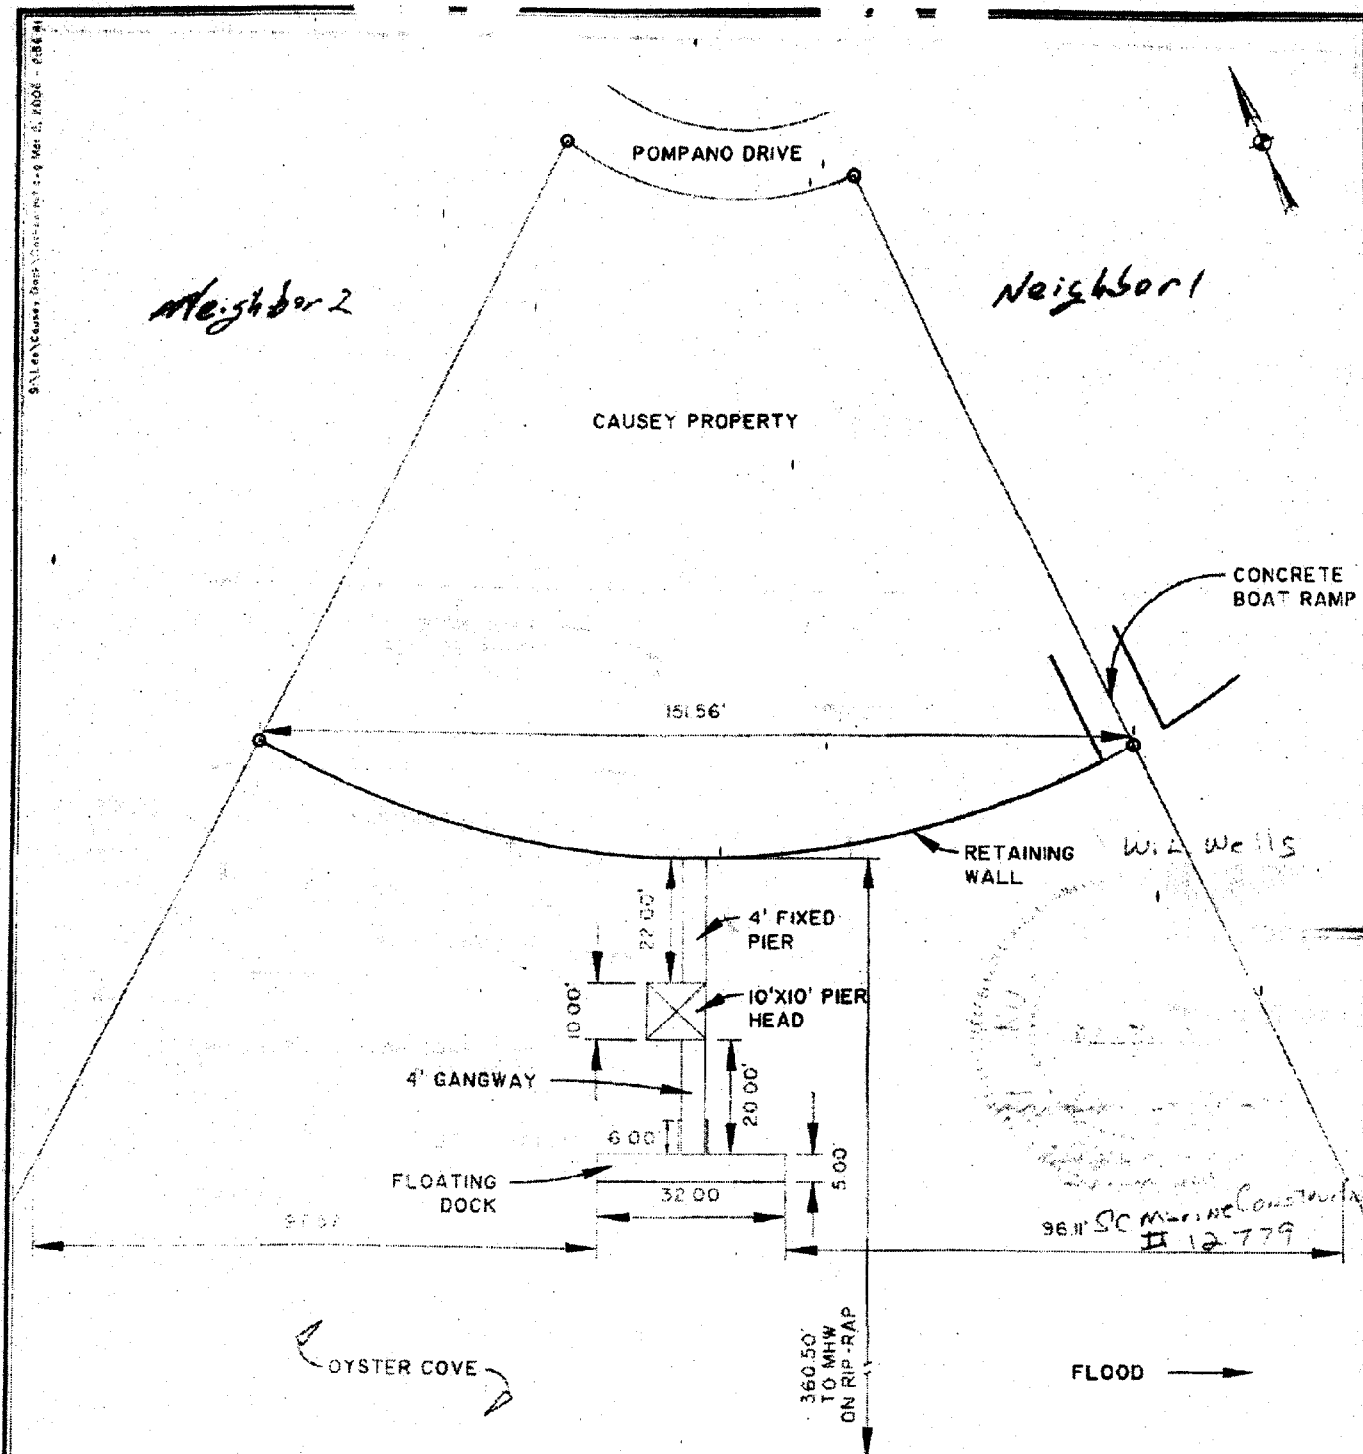

PROPOSED SITE PLAN

SCALE: 1"=30'

0 15 30 60 90

DATE: MARCH 2, 2006

REVISED:

SHEET 2 OF 3

PROPOSED ACTIVITY:
PRIVATE RESIDENTIAL DOCK


COUNTY: GEORGETOWN

APPLICANT: ROBBY CAUSEY

OCRM-06-512

CURVE TABLE

CURVE	RADIUS	DELTA	ANGLE	BEARING	CHORD	LENGTH
C1	50.00	81°03'41"	S65°30'32"E	50.80	53.28	
C2	118.00	81°34'42"	S72°44'44"E	151.58	185.18	

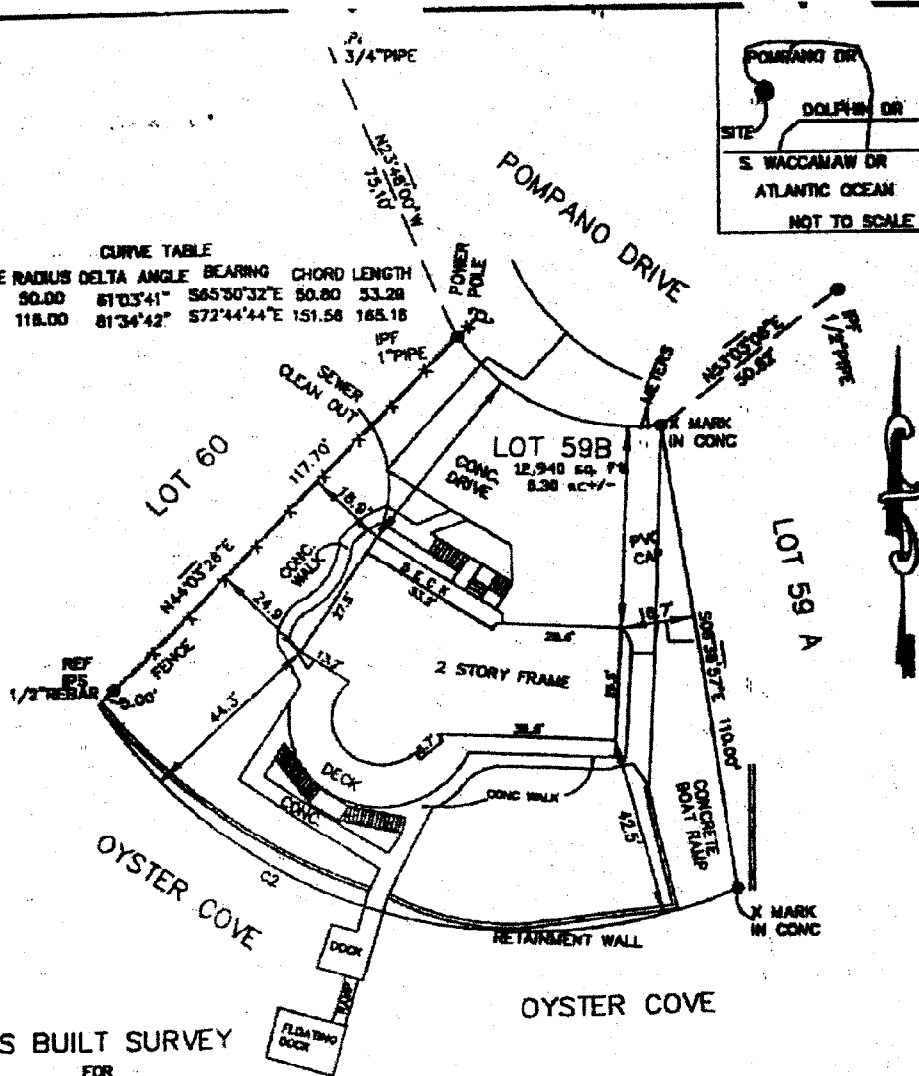


AS BUILT SURVEY
FOR
ROBBY L. CAUSEY


OF
LOT 59B
WILET POINT, GARDEN CITY
TOWNSHIP, GEORGETOWN COUNTY, SOUTH CAROLINA, RECORDED IN THE
OFFICE OF THE CLERK OF COURT FOR GEORGETOWN COUNTY IN PLAT BOOK I PAGE 58
DEED BOOK 1788 PAGE 328
SUBJECT TO EASEMENTS AND RESTRICTIONS OF RECORD. TAX MAP: 41-131-032
TITLE SEARCH NOT FURNISHED.

FLOOD HAZARD ZONE VE BASE FLOOD ELEVATION 16' COMMUNITY 450085 PANEL 4500850167 E DATE 10-18-1982

I HEREBY STATE THAT TO THE BEST OF MY KNOWLEDGE, INFORMATION AND BELIEF, THE SURVEY SHOWN HERE ON
WAS MADE IN ACCORDANCE WITH THE REQUIREMENTS OF THE MINIMUM STANDARDS MANUAL FOR THE PRACTICE
OF LAND SURVEYING IN SOUTH CAROLINA, AND MEETS OR EXCEEDS THE REQUIREMENTS FOR A CLASS B
SURVEY AS SPECIFIED THEREIN; ALSO THERE ARE NO ENCROACHMENTS
OR PROJECTIONS OTHER THAN SHOWN. AREA BY DMD METHOD.

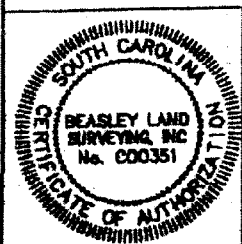

THE INFORMATION SHOWN ON THIS DRAWING IS
REPRESENTATIVE OF THE RESULTS OF A FIELD
SURVEY PERFORMED BY BEASLEY LAND
SURVEYING, INC. ON OR BEFORE THE 28TH
DAY OF MARCH 20 05.
THIS SURVEY IS RELIABLE ONLY ON THIS DATE
AND MAY NOT BE USED FOR ANY PURPOSE OTHER
THAN STATED HEREON, OR BY ANY OTHER PERSONS
PARTIES OR OFFICES.

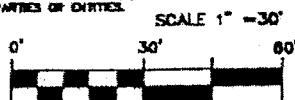

BEASLEY LAND SURVEYING, INC.
8084 FRIENDSHIP LANE
P.O. BOX 30784
MYRTLE BEACH, S.C. 29568
843-850-7722
FAX 843-850-7723

LARRY T. BEASLEY S.C. RPLS 8544
© 2005 ALL RIGHTS RESERVED
DATE MARCH 28, 2005

REVISED: MAR. 9, 2006, NAME CHANGE, UPDATE PLAT, SITE INVESTIGATION

OCRM-06-512